



Bauteile												
Pos	Bezeichnung	KKS-Nr./Change	DN 1	DN 2	Norm	Menge	Da 1	s 1	Da 2	s 2	Radius	Material
[1]	Halterung		200			3						
[2]	Halterung		150			1						
[3]	Halterung		125			1						
[4]	Halterung		100			1						
[5]	Rohr	431311	100		DN EN 10217-7	314 mm	114.3	6				14.435
[6]	Blindflansch PN40	12A0218-1T5 11CT18682	100		DN EN 1092-1	5						14.435
[7]	Bogen BA3 90°	92084./3	100		ähnlich DIN 2605	1	114.3	3			152	14.404
[8]	Rohr	421855	100		DN EN 10217 - 7	282 mm	114.3	3				14.435
[9]	Bogen BA5 36°	92084./3	100		ähnlich DIN 2605	2	114.3	3			270	14.404
[10]	Reduzierung	420154	100	125	DN 2616-2-K	1	114.3	4	139.7	4		14.435
[11]	Blindflansch PN40	TH7057	200		DN EN 1092-1	1						14.404
[12]	Flansch PN40	09A1109-134.9	200		DN 2635	1						14.404
[13]	Rohr	389200	200		DN EN 10217 - 7	644.5 mm	219.1	4				14.435
[14]	Bogen BA3 90°	528620	200		ähnlich DIN 2605	2	219.1	5			305	14.404
[15]	Bogen BA5 36°	528620	200		ähnlich DIN 2605	3	219.1	5			510	14.404
[16]	Reduzierung	431311	150	200	DN 2616-2-K	1	168.3	5	219.1	5		14.435
[17]	Rohr	389200	150		DN EN 10217 - 7	288 mm	168.3	4				14.435
[18]	Bogen BA5 36°	A2205733	150		ähnlich DIN 2605	2	168.3	4			390	14.404
[19]	Reduzierung	420154	125	150	DN 2616-2-K	1	139.7	4	168.3	4		14.435
[20]	Rohr	389200	125		DN EN 10217 - 7	2987 mm	139.7	4				14.435
[21]	Bogen BA5 36°	A2205733	125		ähnlich DIN 2605	2	139.7	4			330	14.404
[22]	Flansch PN40	12CT194.9	100		DN 2635	5						14.435

Halterung		
Halterung Nr.	Typ	Zeichn.-Nr.
BQ01	Festpunkt	
BQ02	Gleitlager	
BQ03	Gleitlager	
BQ04	Gleitlager	
BQ05	Gleitlager	
BQ06	Gleitlager	

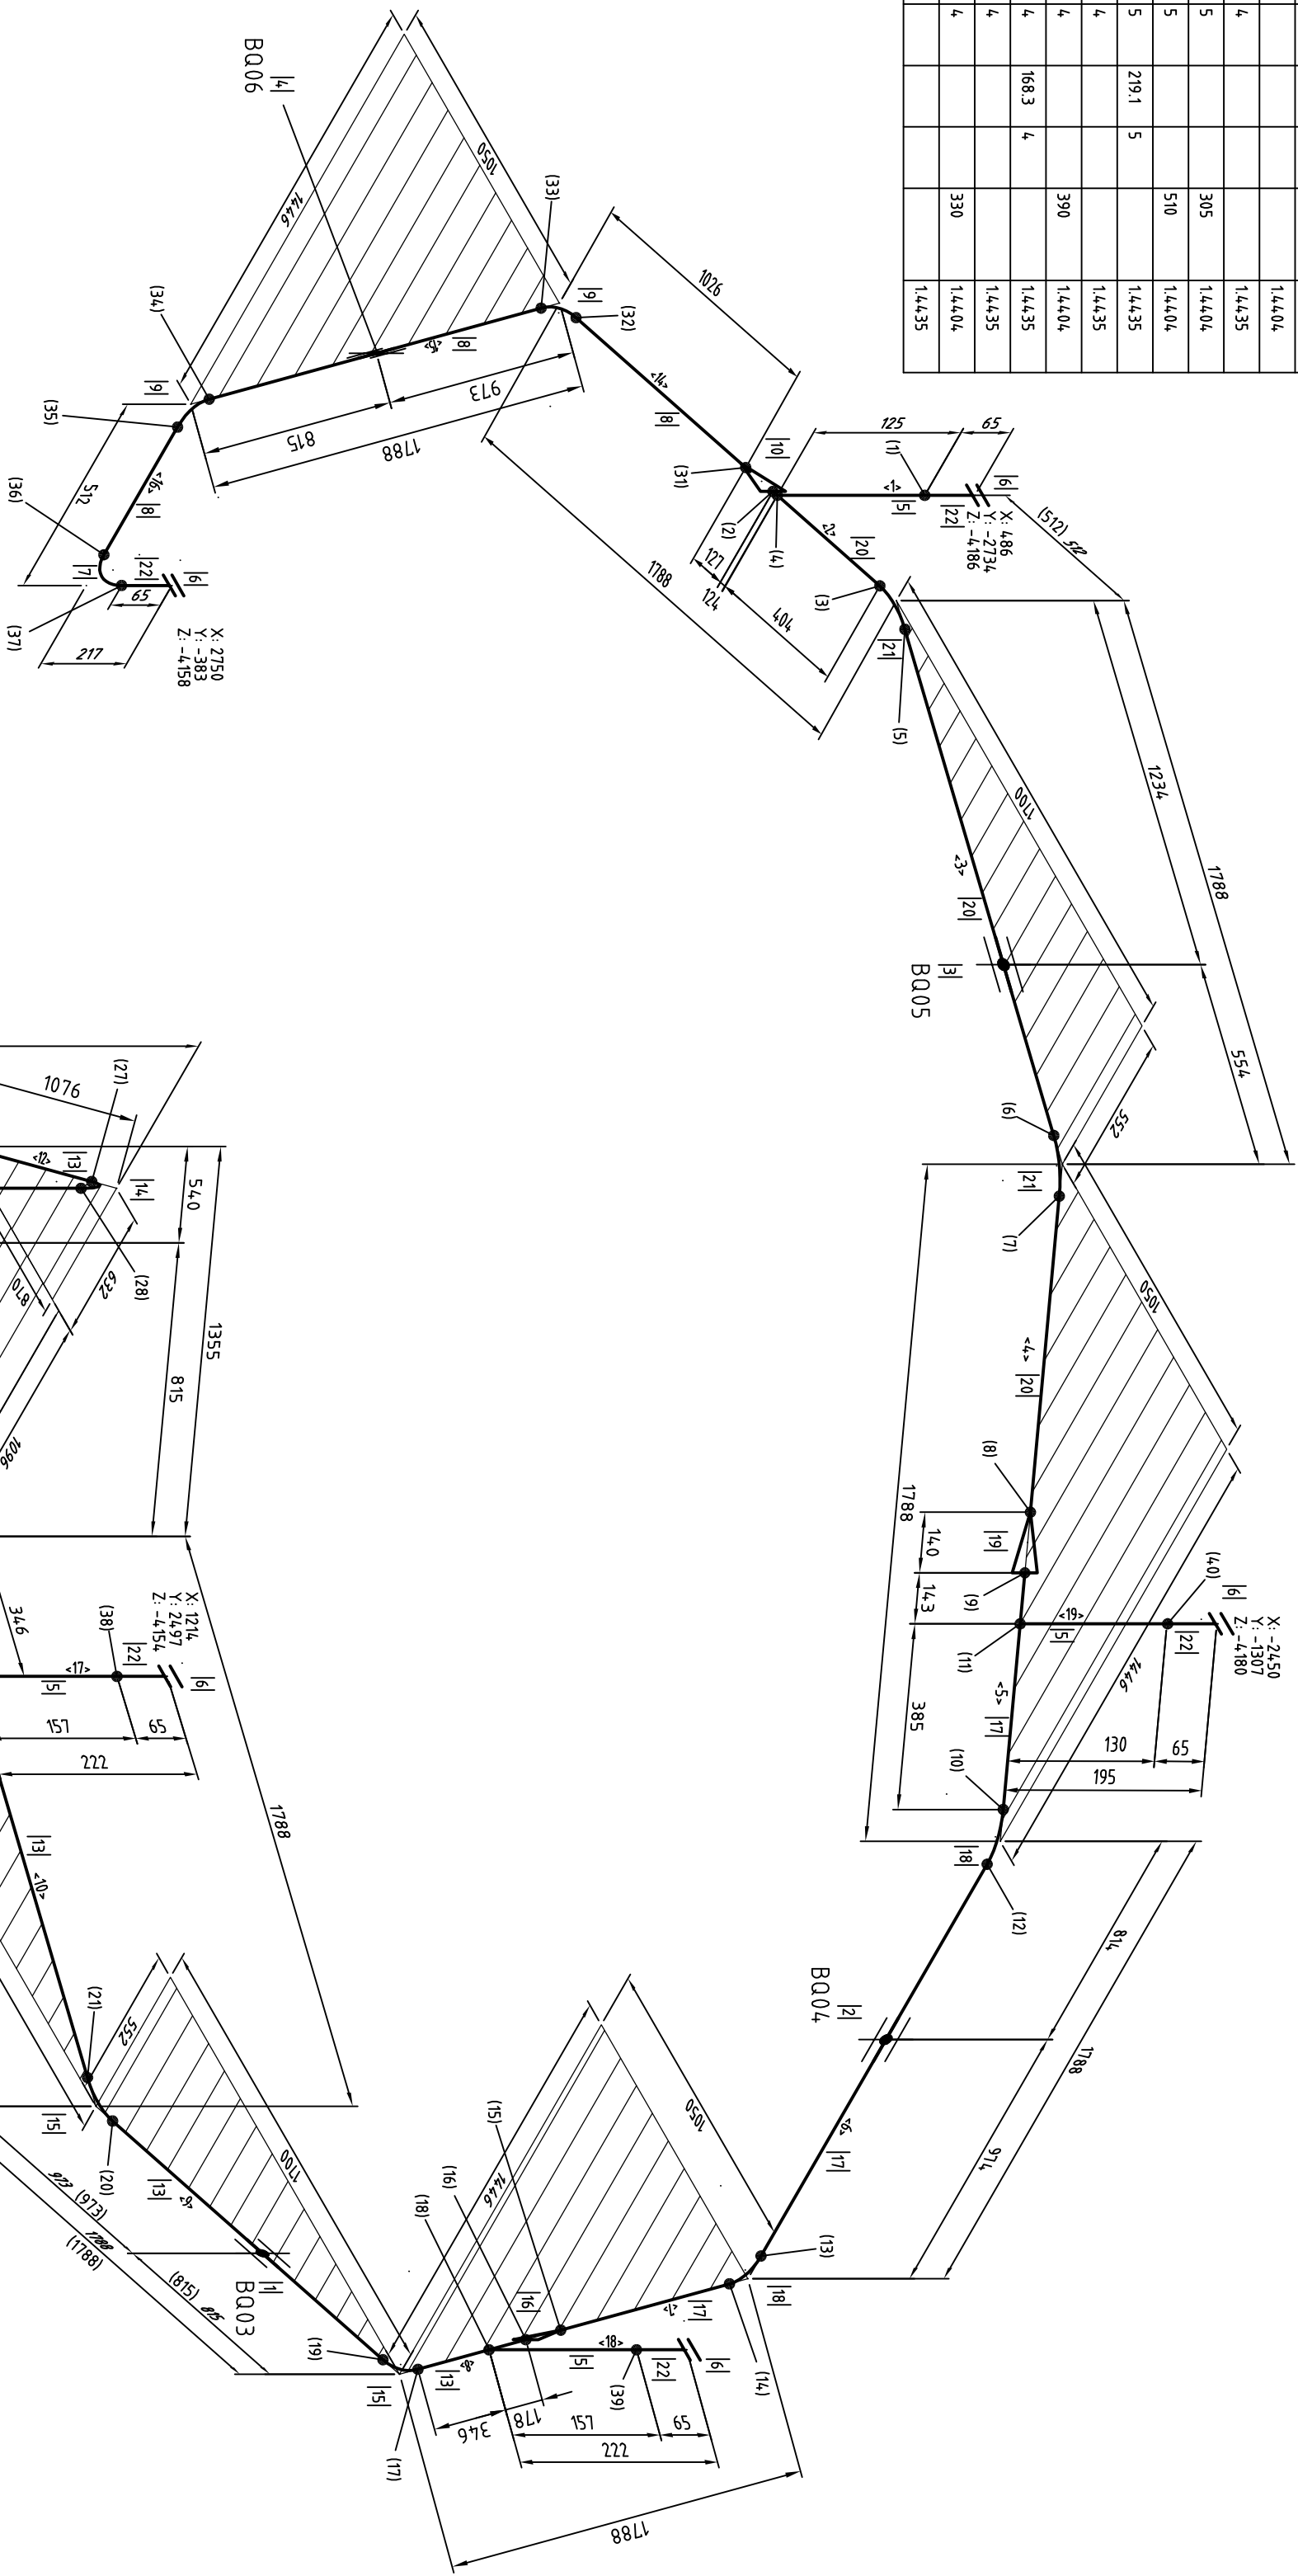

(140)	AKB+08	
(139)	AKB+20	
(38)	AKB+08	
(37)	AKB+20	
(36)	AKB+20	13/0037
(35)	AKB+20	
(34)	AKB+20	
(33)	AKB+20	
(32)	AKB+20	
(31)	AKB+12	
(30)	-----	
(29)	AKB+12	
(28)	AKB+20	
(27)	AKB+20	13/0037
(26)	AKB+20	13/0037
(25)	AKB+08	
(24)	AKB+08	
(23)	AKB+08	
(22)	AKB+08	
(21)	AKB+12	14/0006
(20)	AKB+10	
(19)	AKB+10	13/0037
(18)	AKB+10	
(17)	AKB+10	
(16)	AKB+10	
(15)	AKB+12	
(14)	AKB+08	
(13)	AKB+08	
(12)	AKB+08	
(11)	AKB+08	13/0037
(10)	AKB+08	13/0037
(9)	AKB+08	13/0037
(8)	AKB+12	
(7)	AKB+20	
(6)	AKB+20	
(5)	AKB+20	
(4)	AKB+20	
(3)	AKB+20	
(2)	AKB+20	
(1)	AKB+20	
Pos	Schneißer	Protokoll-Nr.

Pos	L'Ange (mm)	DN
<-19-	73	100
<-18-	68	100
<-17-	68	100
<-16-	212	100
<-15-	1612	100
<-14-	938	100
<-13-	1661	200
<-12-	466	200
<-11-	884	200
<-10-	1456	200
<-9-	1456	200
<-8-	524	200
<-7-	820	150
<-6-	1534	150
<-5-	528	150
<-4-	886	125
<-3-	1573	125
<-2-	528	125
<-1-	107	100

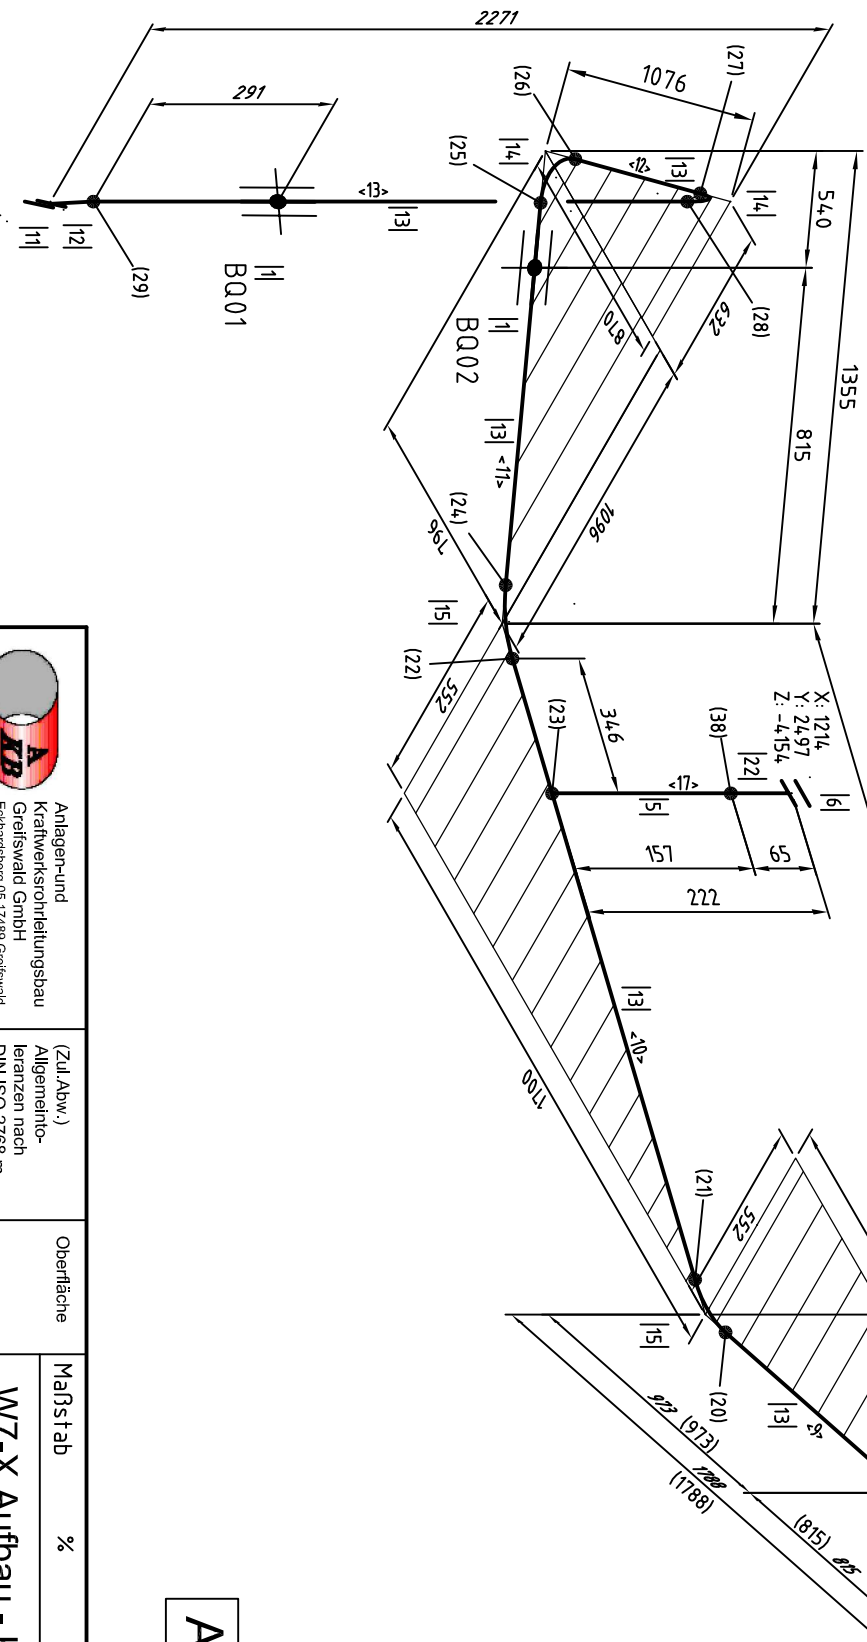

## AS BUILT

[illegible]